


# RIVERSIDE COUNTY FLOOD CONTROL AND WATER CONSERVATION DISTRICT

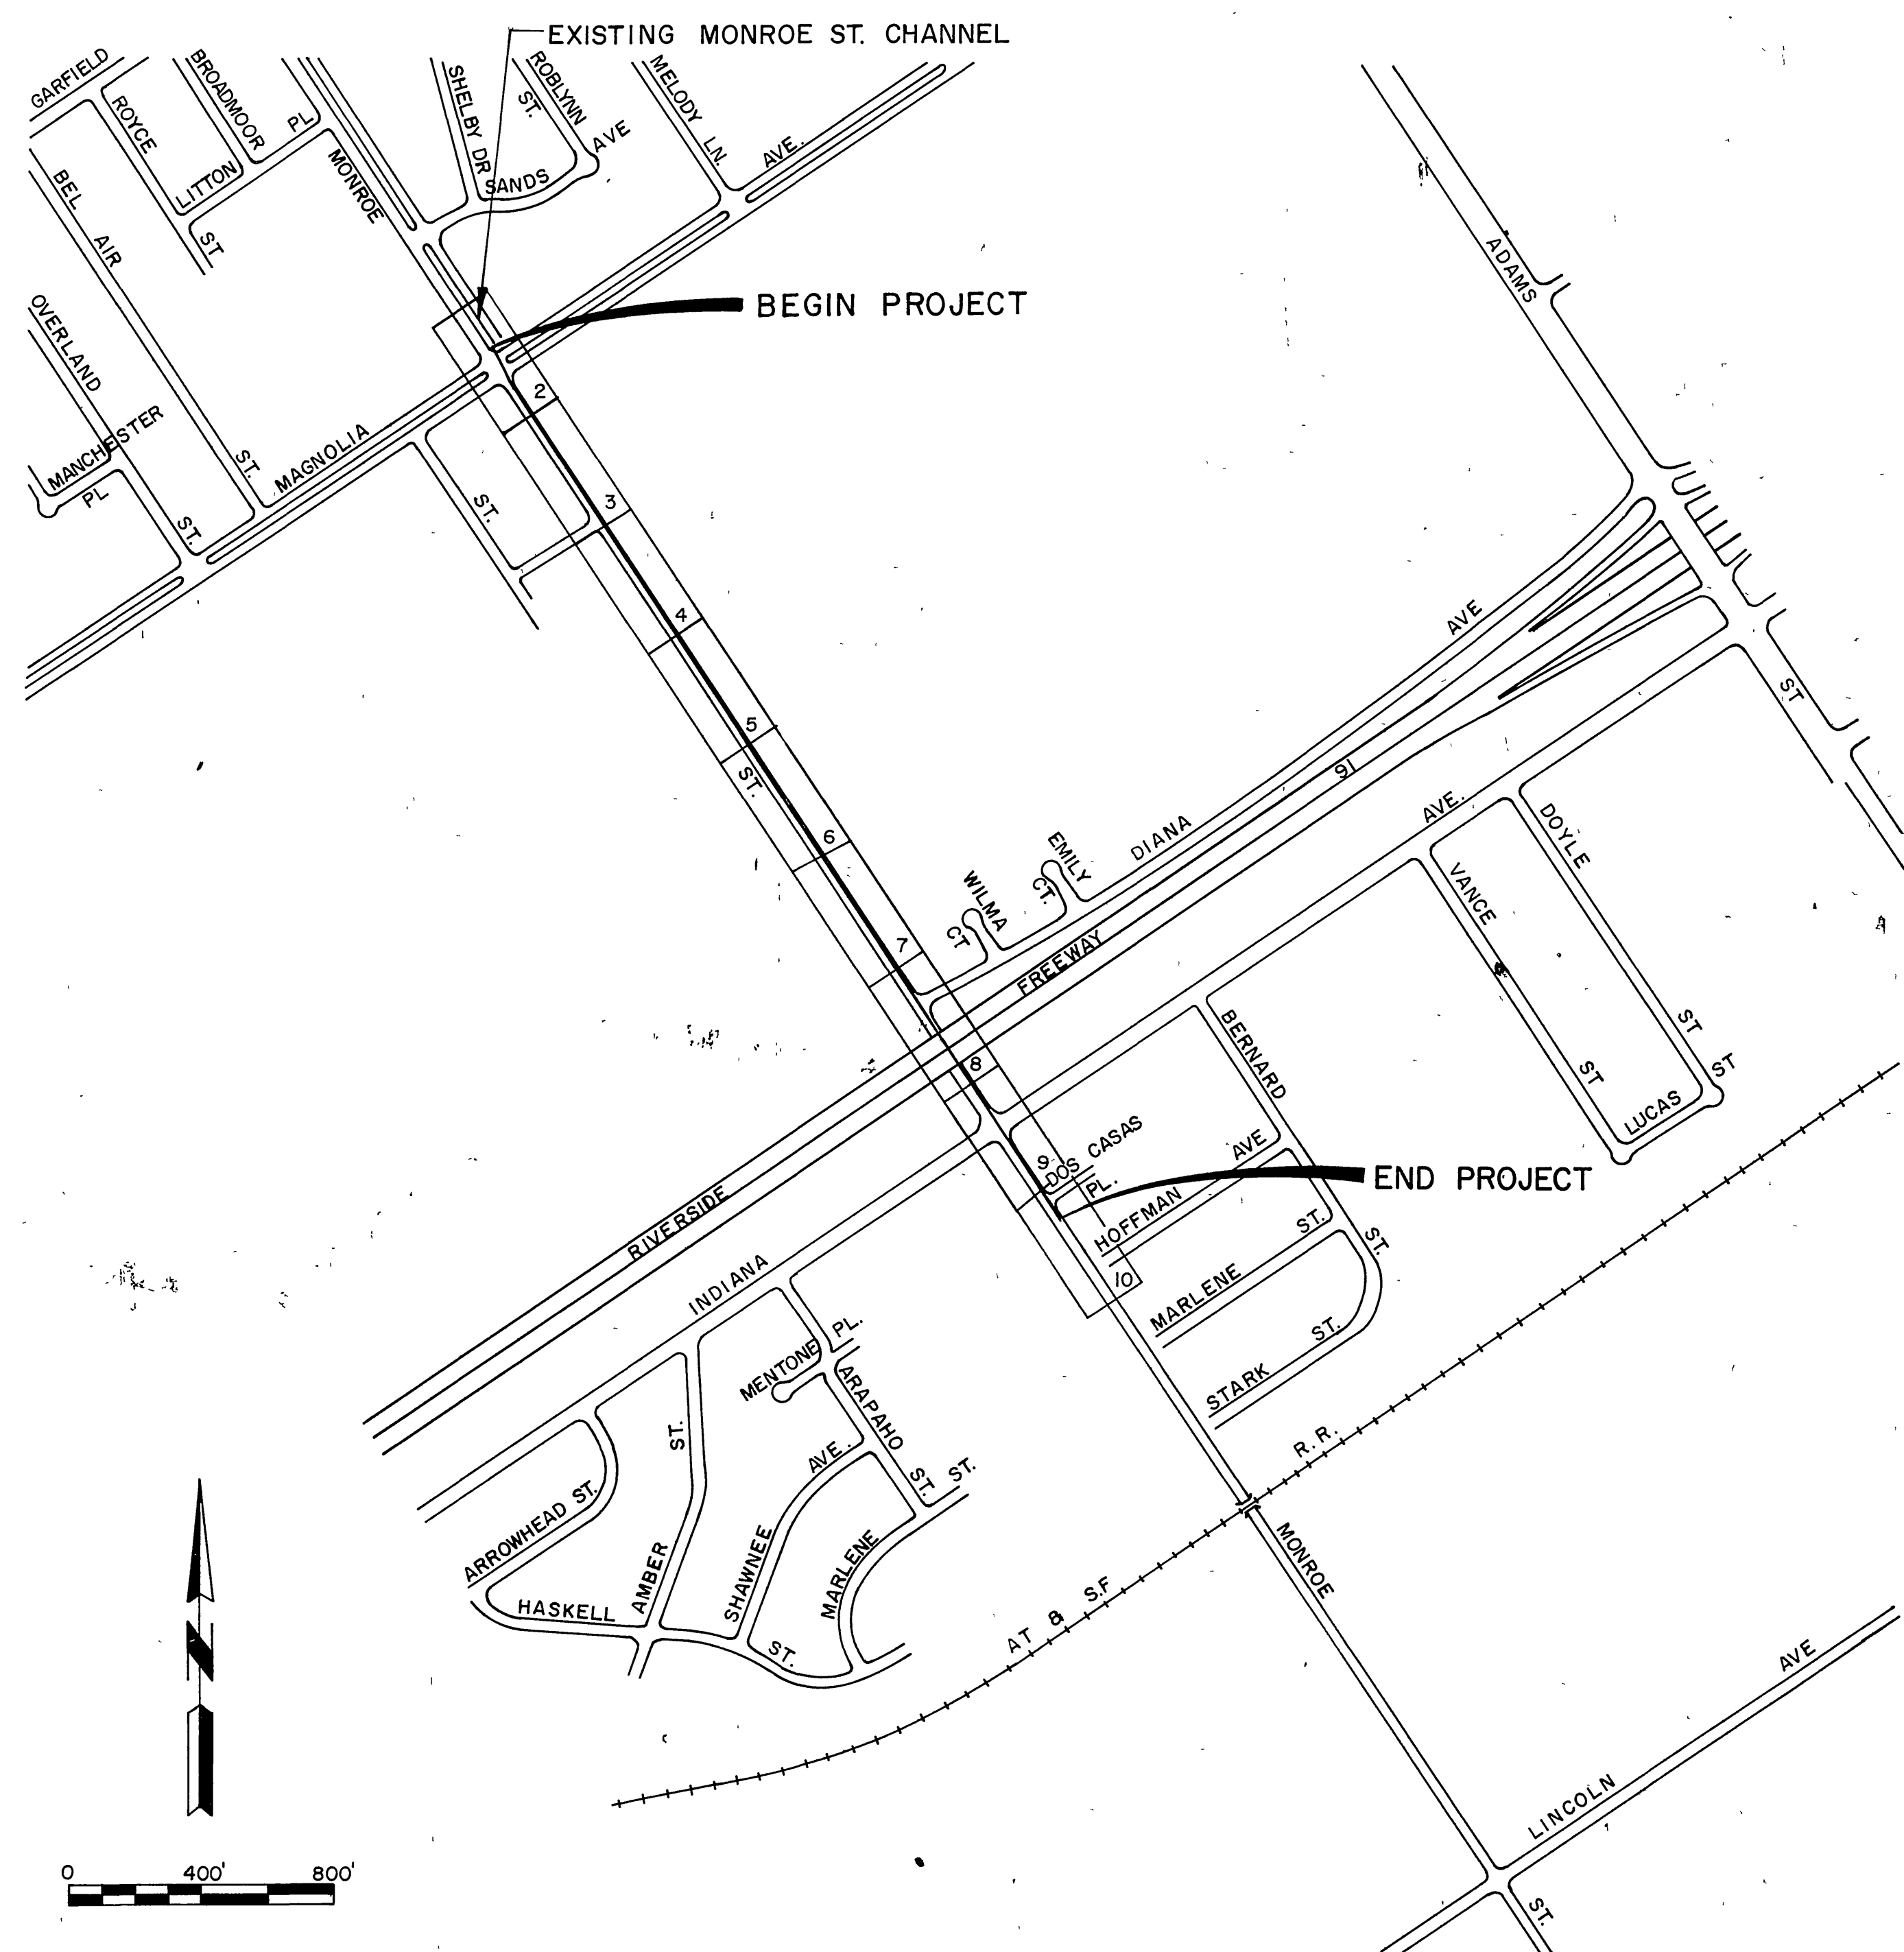

LOCATION MAP

## GENERAL NOTES

1. JUNCTION STRUCTURE NO. 4 (PIPE) OR JUNCTION STRUCTURE NO. 3 (CHANNEL) SHALL BE CONSTRUCTED FOR JUNCTIONS NOT OTHERWISE SPECIFIED ON THE PLAN AND PROFILE.
2. TIES TO CATCH BASINS ARE FROM THE CURB RETURN TO THE CENTER LINE OF THE CATCH BASIN UNLESS OTHERWISE SHOWN. WHERE NO TIE IS SHOWN L.D. SHALL BEGIN AT THE CURB RETURN.
3. ALL OPENINGS RESULTING FROM CUTTING OR PARTIAL REMOVAL OF EXISTING CULVERTS, PIPES OR SIMILAR STRUCTURES TO BE ABANDONED SHALL BE SEALED WITH 6" OF CLASS "B" CONCRETE, NOTED ON THE DRAWINGS AS "PLUG".
4. STREET RESURFACING SHALL BE 3" AC. ON 6" CLASS 3 A.B. UNLESS OTHERWISE NOTED.
5. ALL RESURFACING, CURBS, GUTTERS, SIDEWALKS, DRIVEWAYS AND OTHER EXISTING IMPROVEMENTS TO BE RECONSTRUCTED SHALL BE CONSTRUCTED AT THE SAME ELEVATION AND LOCATION AS THE EXISTING IMPROVEMENTS, UNLESS OTHERWISE NOTED.
6. "V" IS THE DEPTH OF INLET PIPE OF CATCH BASINS IN SERIES MEASURED FROM TOP OF CURB TO INVERT OF CONNECTOR PIPE.

## INDEX

TITLE SHEET	SHEET NO.
MAIN LINE PLAN AND PROFILE SHEETS	2-10
CONNECTOR PIPE PROFILES	11-12
STRUCTURAL DETAILS	13-14
MISCELLANEOUS DETAILS	15
SEWER RECONSTRUCTION DETAIL	16
TRAFFIC DETAILS	17
TRAFFIC SIGNAL DETAILS	18


## R.C.F.C. & W.C.D. STANDARD DRAWINGS

CB100	CATCH BASIN NO. 1	19
CB103	CATCH BASIN FRAME AND COVER (MANHOLE)	20
CB105	CATCH BASIN DETAIL OF OPENING	21
CB110	CONCRETE DROP INLET	22
LD201	LOCAL DEPRESSION NO. 2	23
JS227	JUNCTION STRUCTURE NO. 2	24-25
JS228	JUNCTION STRUCTURE NO. 3	26
JS229	JUNCTION STRUCTURE NO. 4	27
MH252	MANHOLE NO. 2	28
MH253	MANHOLE NO. 3	29
MH254	MANHOLE NO. 4	30-31
MH255	MANHOLE FRAME AND COVER (NON-ROCKING)	32
MH257	MANHOLE SHAFT	33
MH259	STANDARD DROP STEP	34
TS301	TRANSITION STRUCTURE NO. 1	35
TS303	TRANSITION STRUCTURE NO. 3	36
JS 226	JUNCTION STRUCTURE NO. 1	37

M803	CONCRETE COLLAR FOR PIPES	38
M807	SANITARY SEWER PROTECTION	39
M808	REMODELING DETAILS HOUSE CONNECTION SEWERS	40-41
M813	CURB AND GUTTER	42
M814	ABBREVIATIONS AND SYMBOLS	43
M815	BEDDING AND PAY LINES	44
M816	CONCRETE BULKHEAD	45

## CITY OF RIVERSIDE STANDARD DRAWINGS

304	WHEELCHAIR RAMPS	46-47
452	STANDARD PIPE BEDDINGS (STORM DRAINS & SEWERS)	48-49
453	TRENCH BACKFILL	50-51
500	PRECAST CONCRETE SEWER MANHOLE	52
504	DROP MANHOLE (FOR TRUNK SEWERS)	53
505	BRICK SEWER MANHOLE	54
606	TRAFFIC SIGNAL PULLBOX	55
900	CHAIN LINK FENCE	56
540	MANHOLE CASTINGS	57

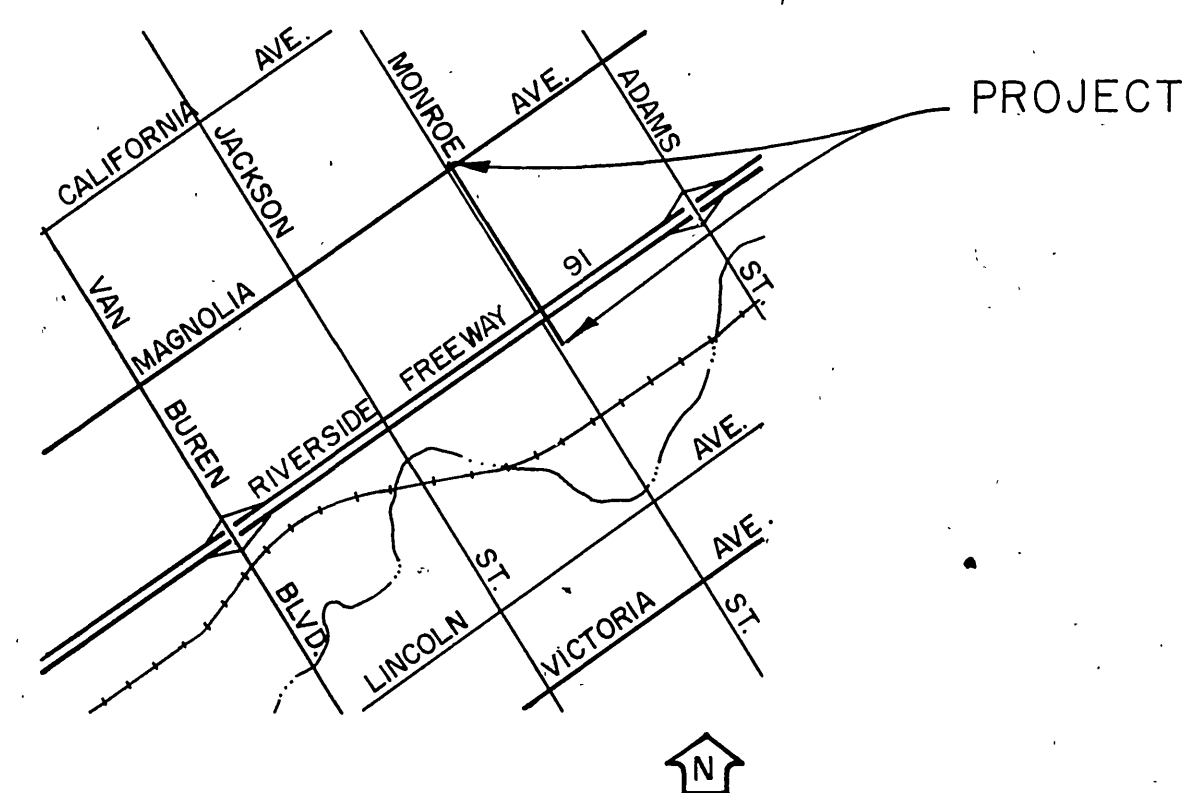

VICINITY MAP  
NO SCALE

REVISIONS		RIVERSIDE COUNTY FLOOD CONTROL AND WATER CONSERVATION DISTRICT		MONROE STORM DRAIN		INDEX OF	
		DESIGNED BY: A.G.K.		STAGE I		PROJECT NO. 1-0-071	
		DRAWN BY: S. Murray		TITLE SHEET		DRAWING NO. 1-313	
		DATE DRAWN:		DATE: 11-3-76		SHEET NO. 1 OF 57	
		CHECKED BY:		1970 STORM DRAIN BOND ISSUE PROJECT NO. 17			

AS BUILT

D-524 IS A  
DUPLICATE OF  
D-352

FILE IN D-524